


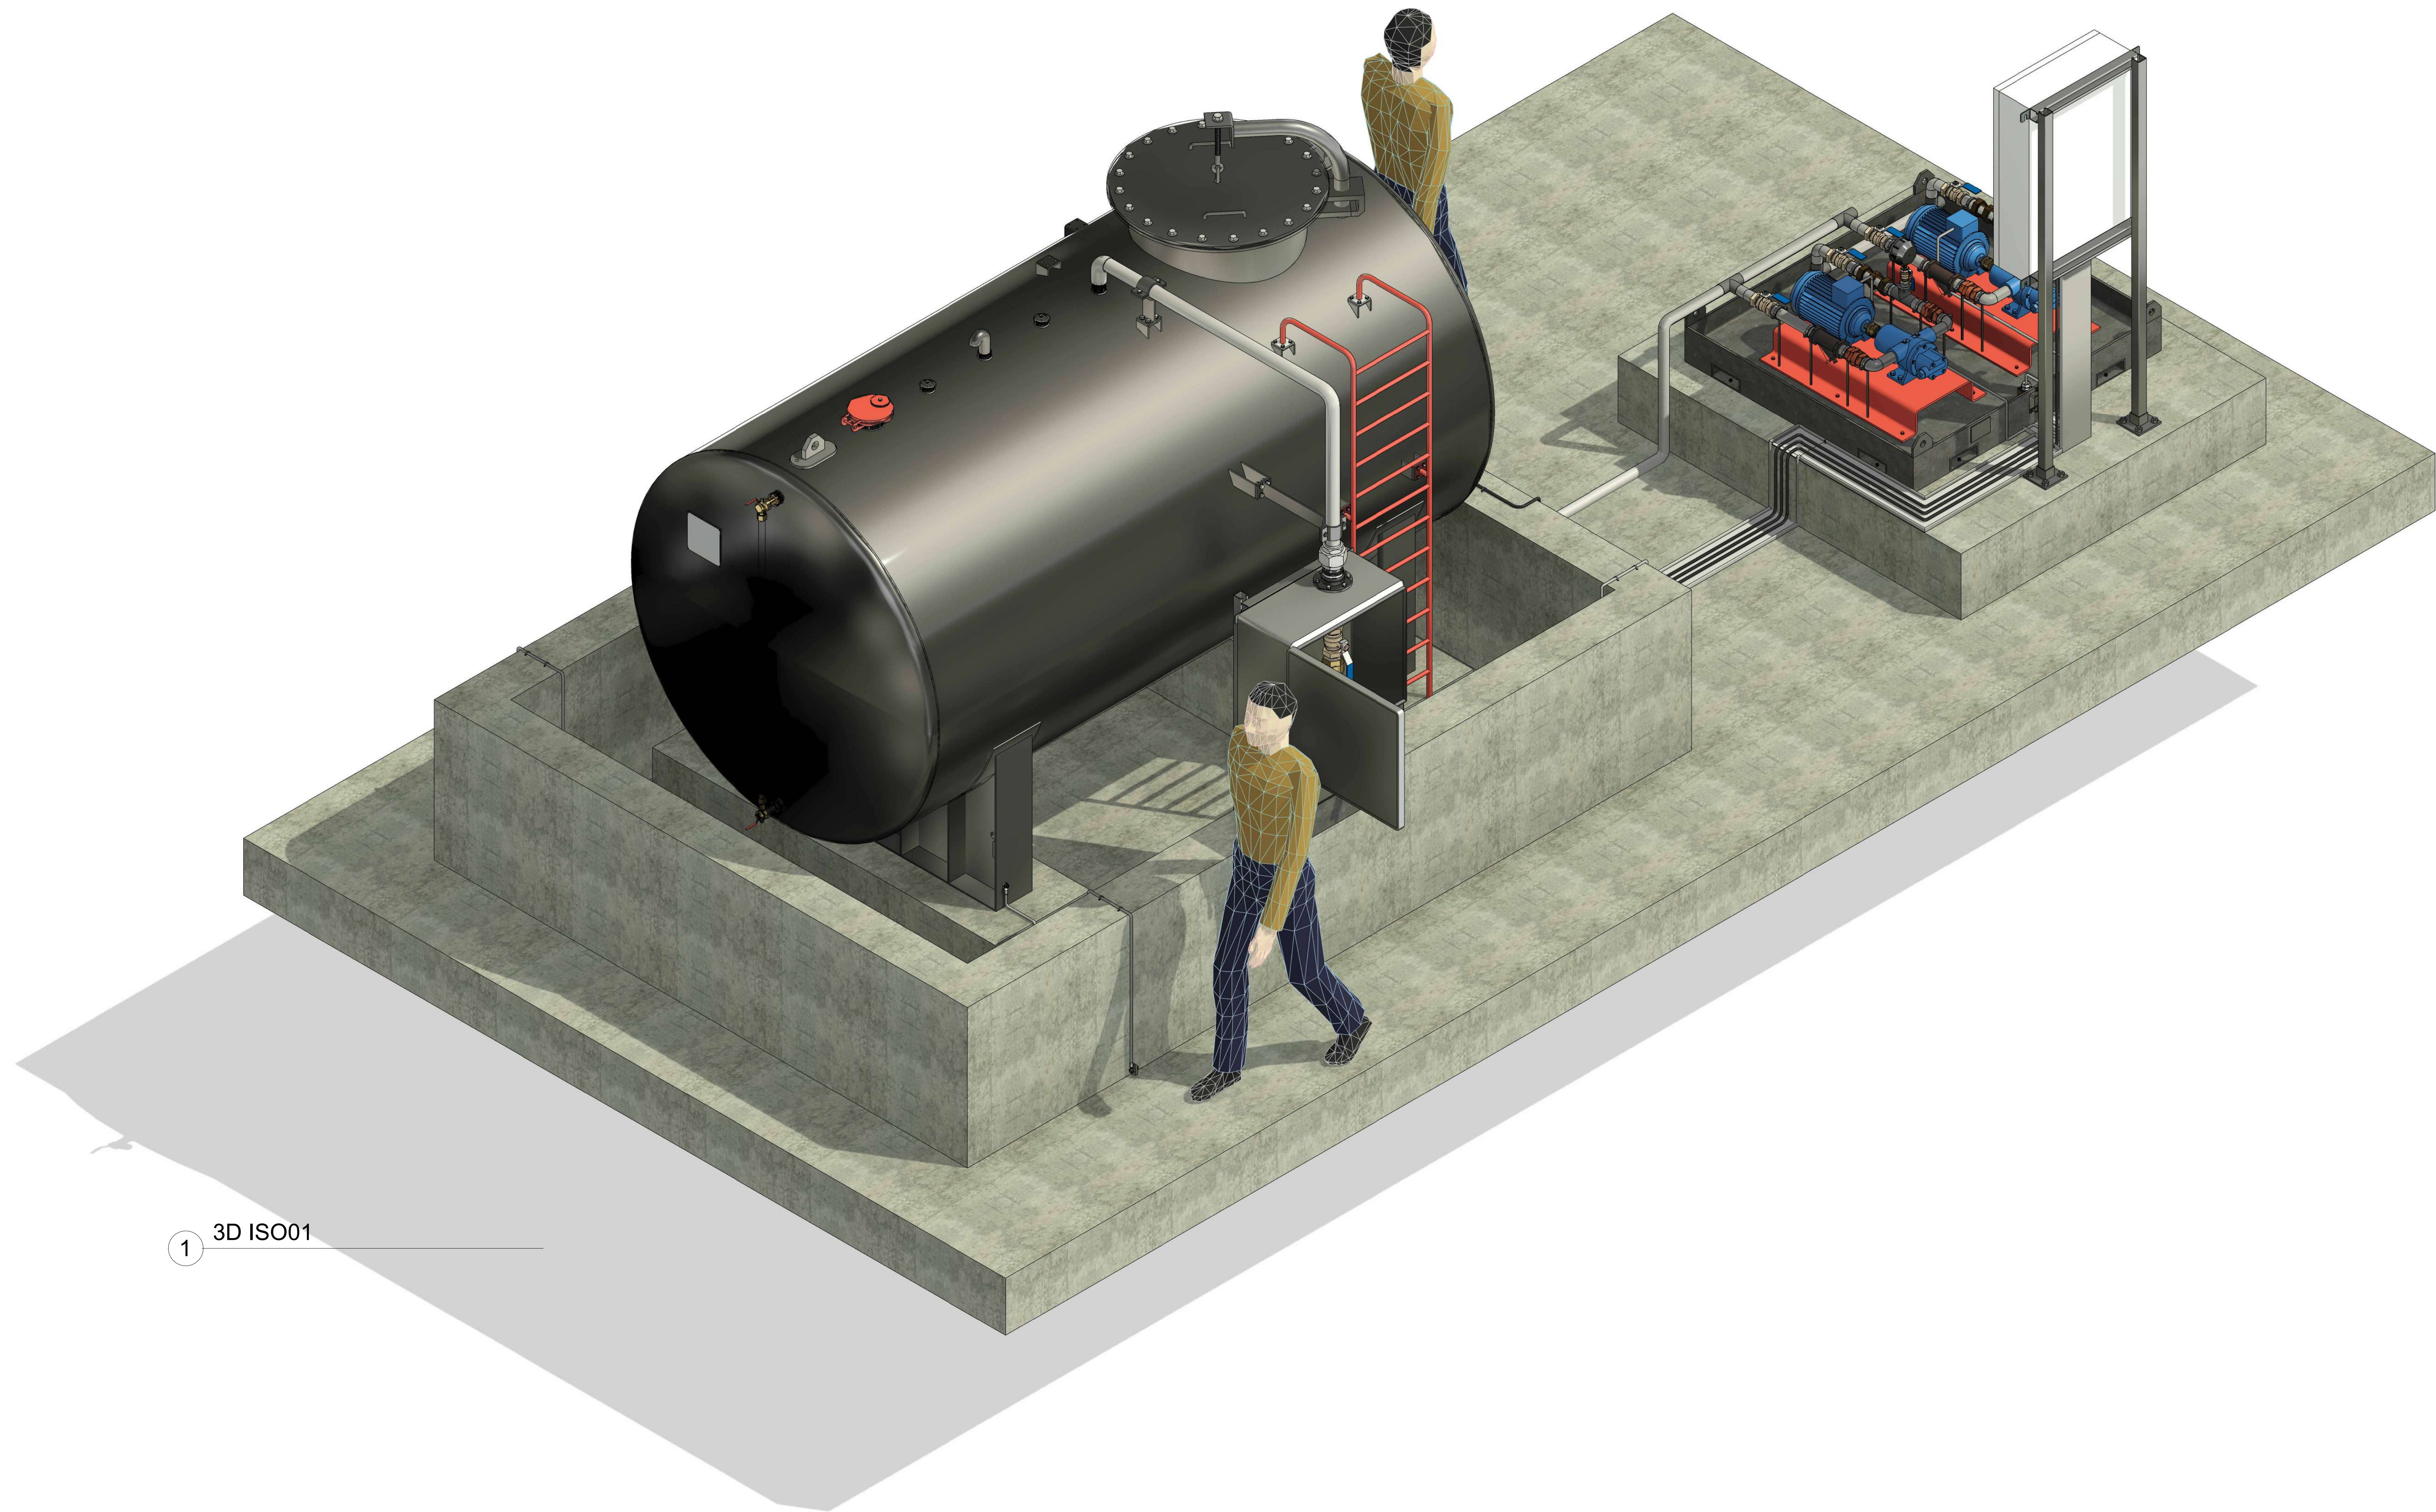

1 3D ISO01

Red Sea
Global

دار الرياض
DAR AL RIYADH

البحر
ALBAHADH
1971

باسية للمقاولات
Basia Contracting
www.basiiia.com

REVISION HISTORY

No.	Date	Description	Status


PROJECT NAME	REDSEA COSTAL VILLAGE - TEMPORARY OFFICE
PROJECT DESCRIPTION	TRANSFER SYSTEM - 6,000L FUEL TANK
BUILDING NAME	
PROJECT NUMBER	R03-O03C02
DRAWING STATUS	AS BUILT

PROJECT STAGE	AS BUILT
DISCIPLINE	
SCALE	
DATE	2024-01-10
DRAWN BY	KN
CHECKED BY	FS
APPROVED BY	YM

DRAWING TITLE


3D 01
A100

PROGRAM CODE	PROJECT & CONTRACTOR CODE	ORIGINATOR CODE	VOLUME / SYSTEM	BUILDING LEVELS	DOCUMENT TYPE	DISCIPLINE	SERIES NUMBER	REVISION

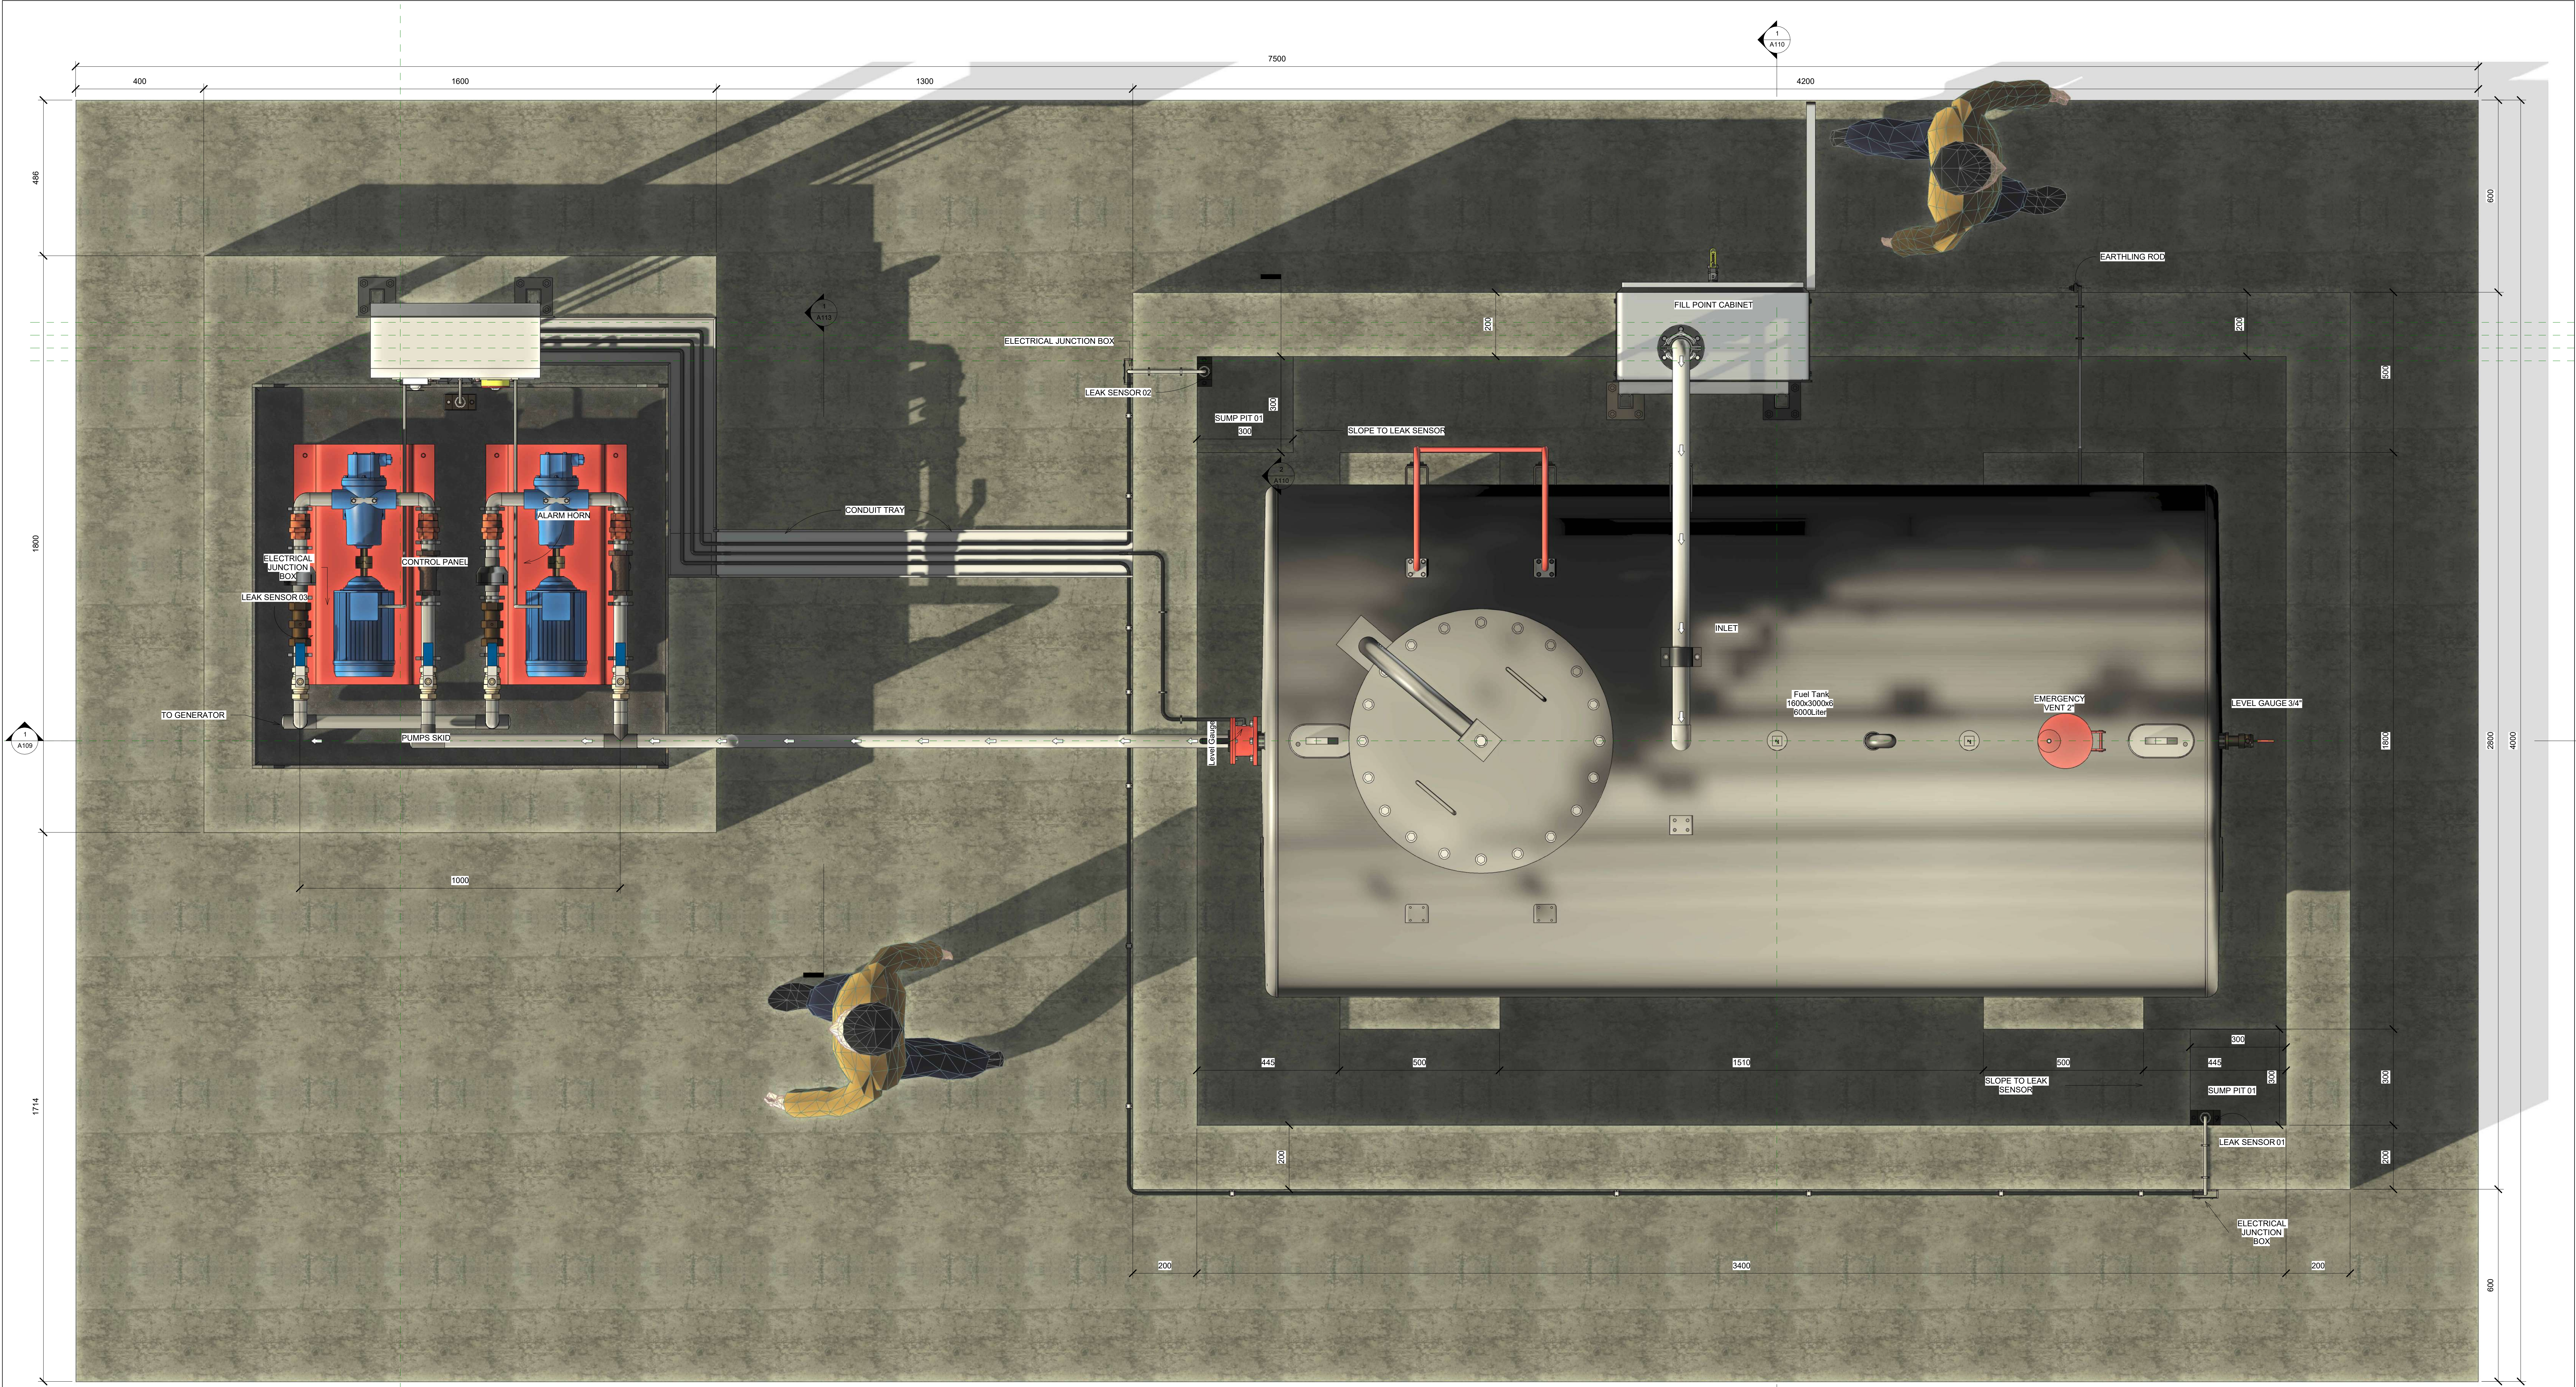


1 TOP VIEW
1:7

CLIENT		CONSULTANT		CONTRACTOR		VENDOR	 www.basila.com	REVISION HISTORY				PROJECT NAME		PROJECT STAGE		DRAWING TITLE TOP VIEW A104									
								No. Date Description Status				REDSEA COSTAL VILLAGE - TEMPORARY OFFICE		AS BUILT											
												PROJECT DESCRIPTION		DISCIPLINE											
												TRANSFER SYSTEM - 6,000L FUEL TANK													
												BUILDING NAME		SCALE											

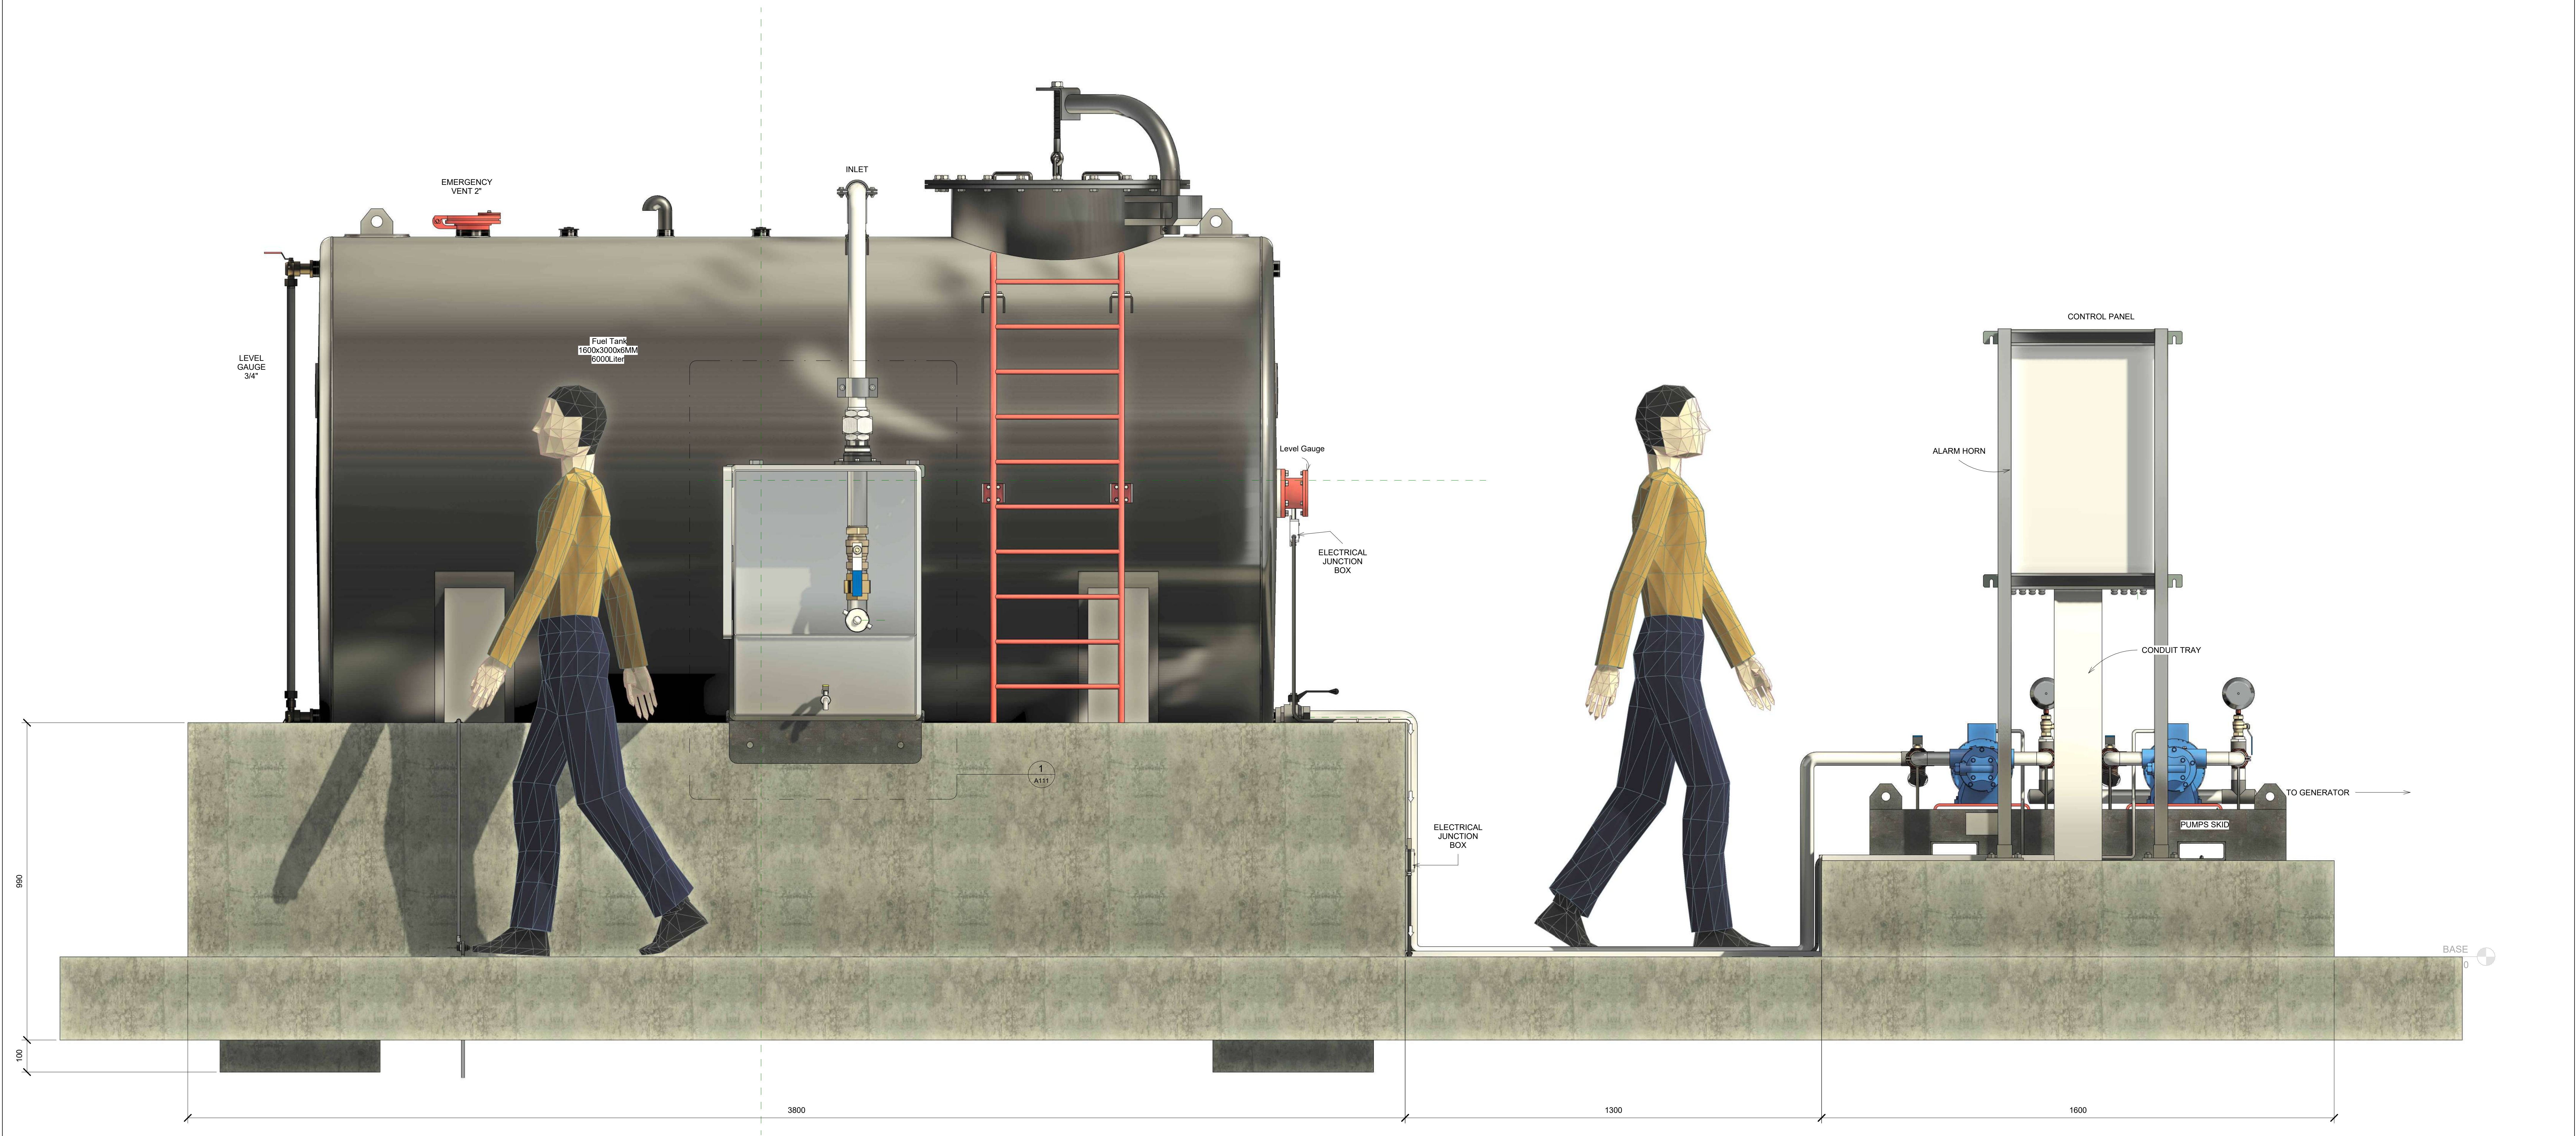

4 West View
1 : 7

CLIENT		CONSULTANT		CONTRACTOR		VENDOR	 www.basila.com	REVISION HISTORY				PROJECT NAME REDSEA COSTAL VILLAGE - TEMPORARY OFFICE		PROJECT STAGE AS BUILT		DRAWING TITLE <								
--------	--	------------	---	------------	--	--------	---	------------------	--	--	--	---	--	---------------------------	--	--	--	--	--	--	--	--	--	--

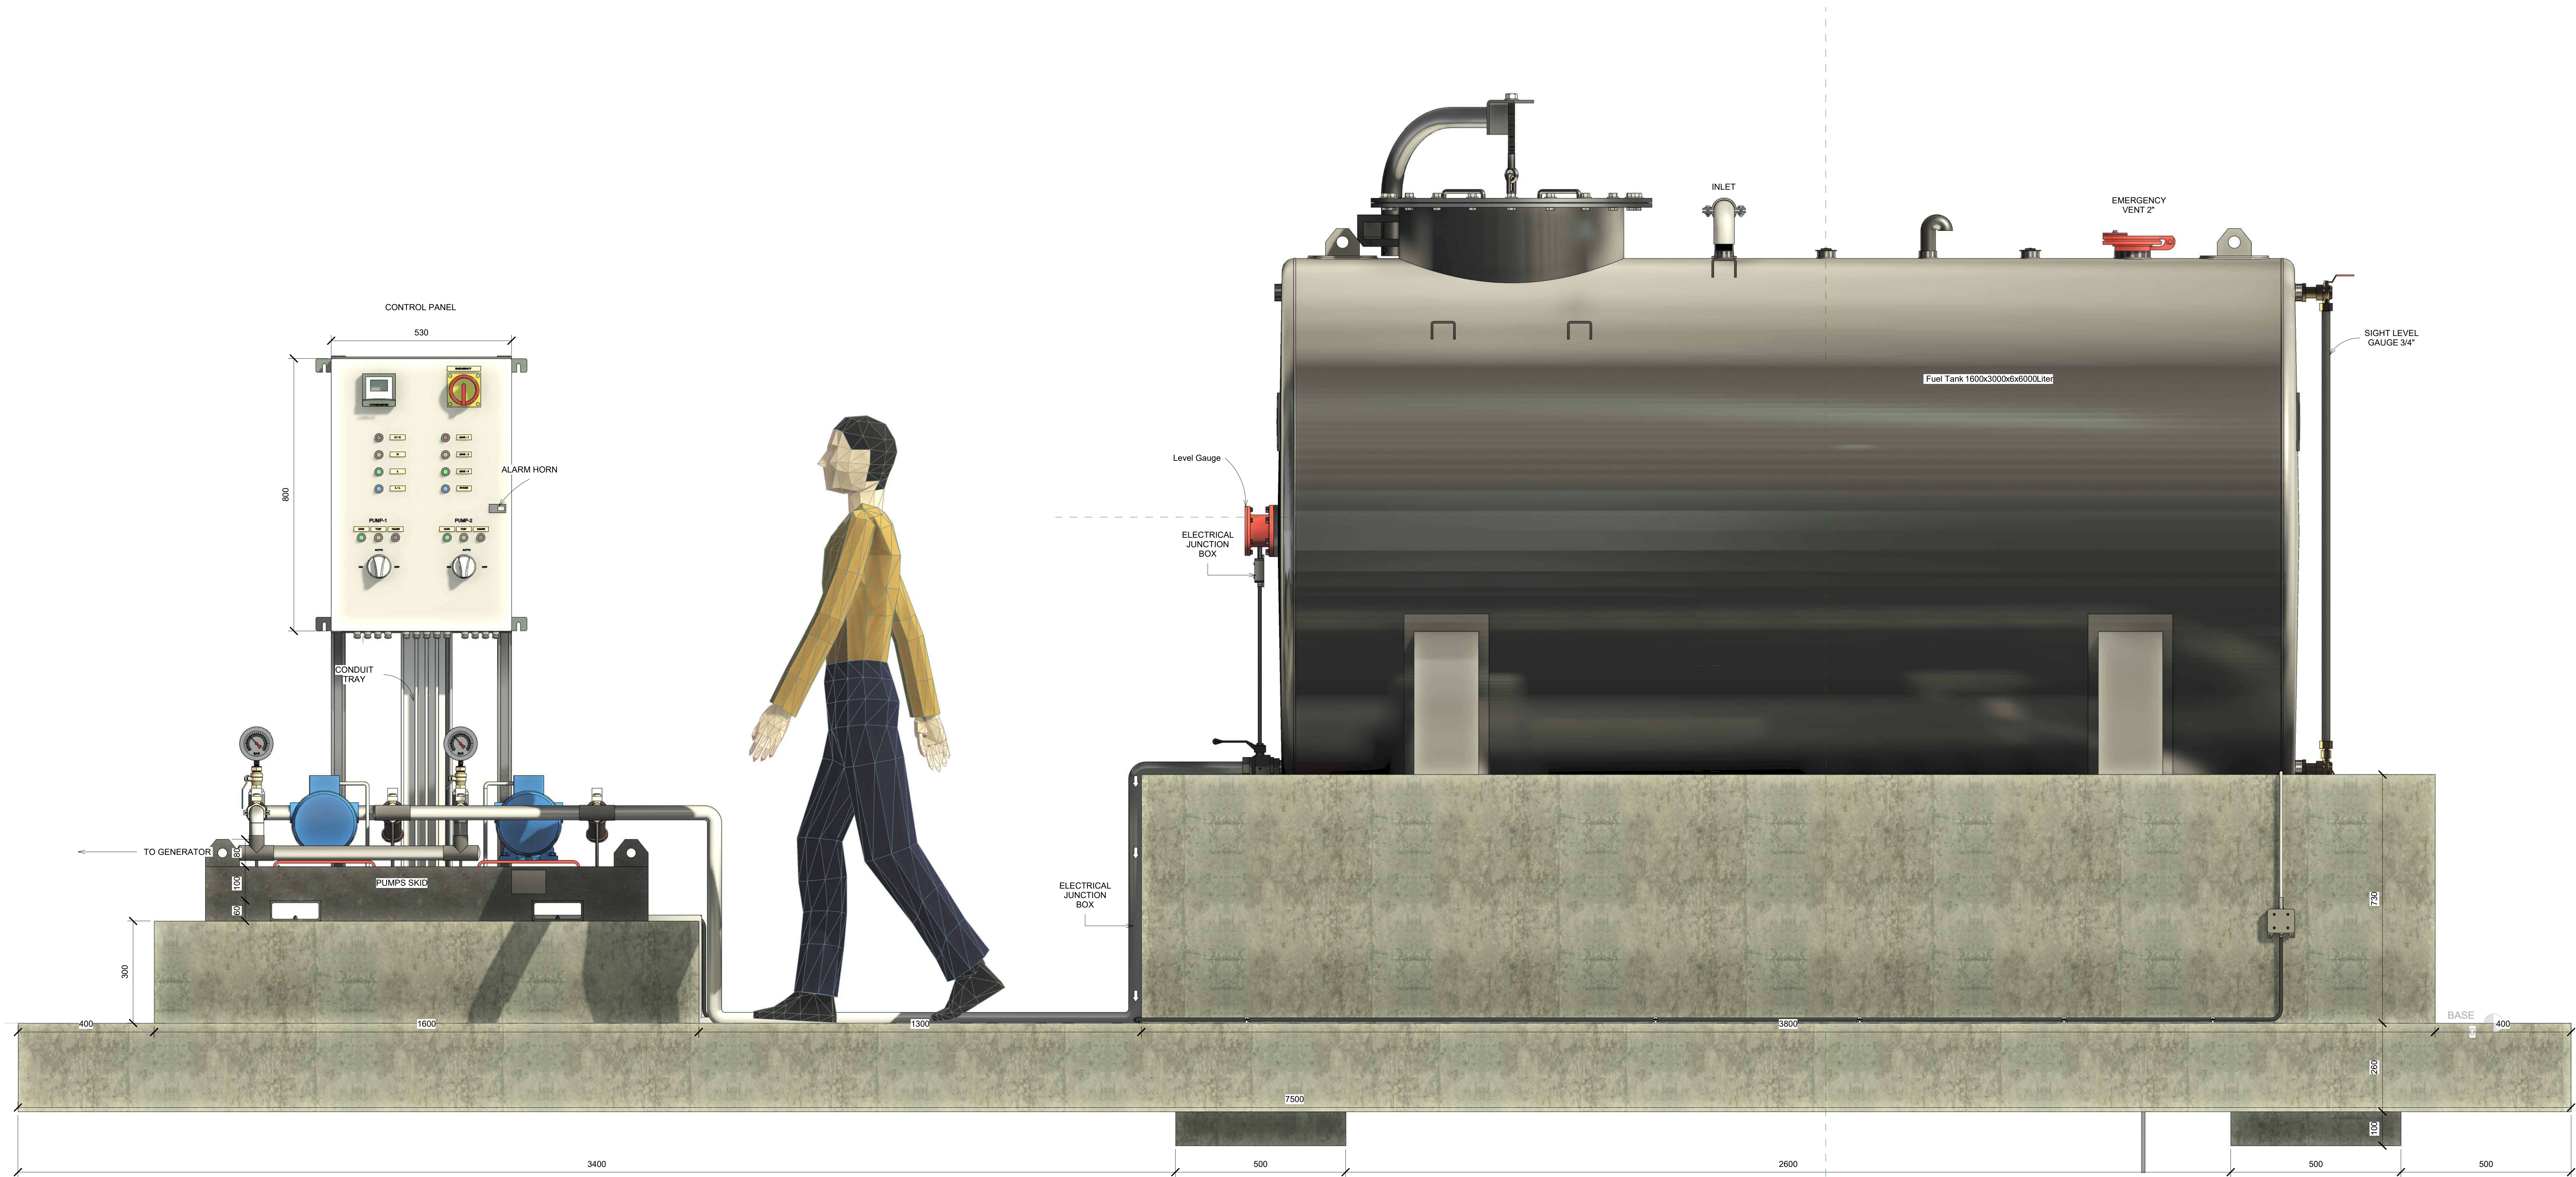


5 East View
1:7

CLIENT		CONSULTANT		CONTRACTOR		VENDOR	 www.basila.com	REVISION HISTORY				PROJECT NAME		PROJECT STAGE		DRAWING TITLE <									
--------	--	------------	---	------------	--	--------	---	------------------	--	--	--	--------------	--	---------------	--	--	--	--	--	--	--	--	--	--	--


11/10/2024 8:51:33 PM

1/10/2024 8:51:45 PM

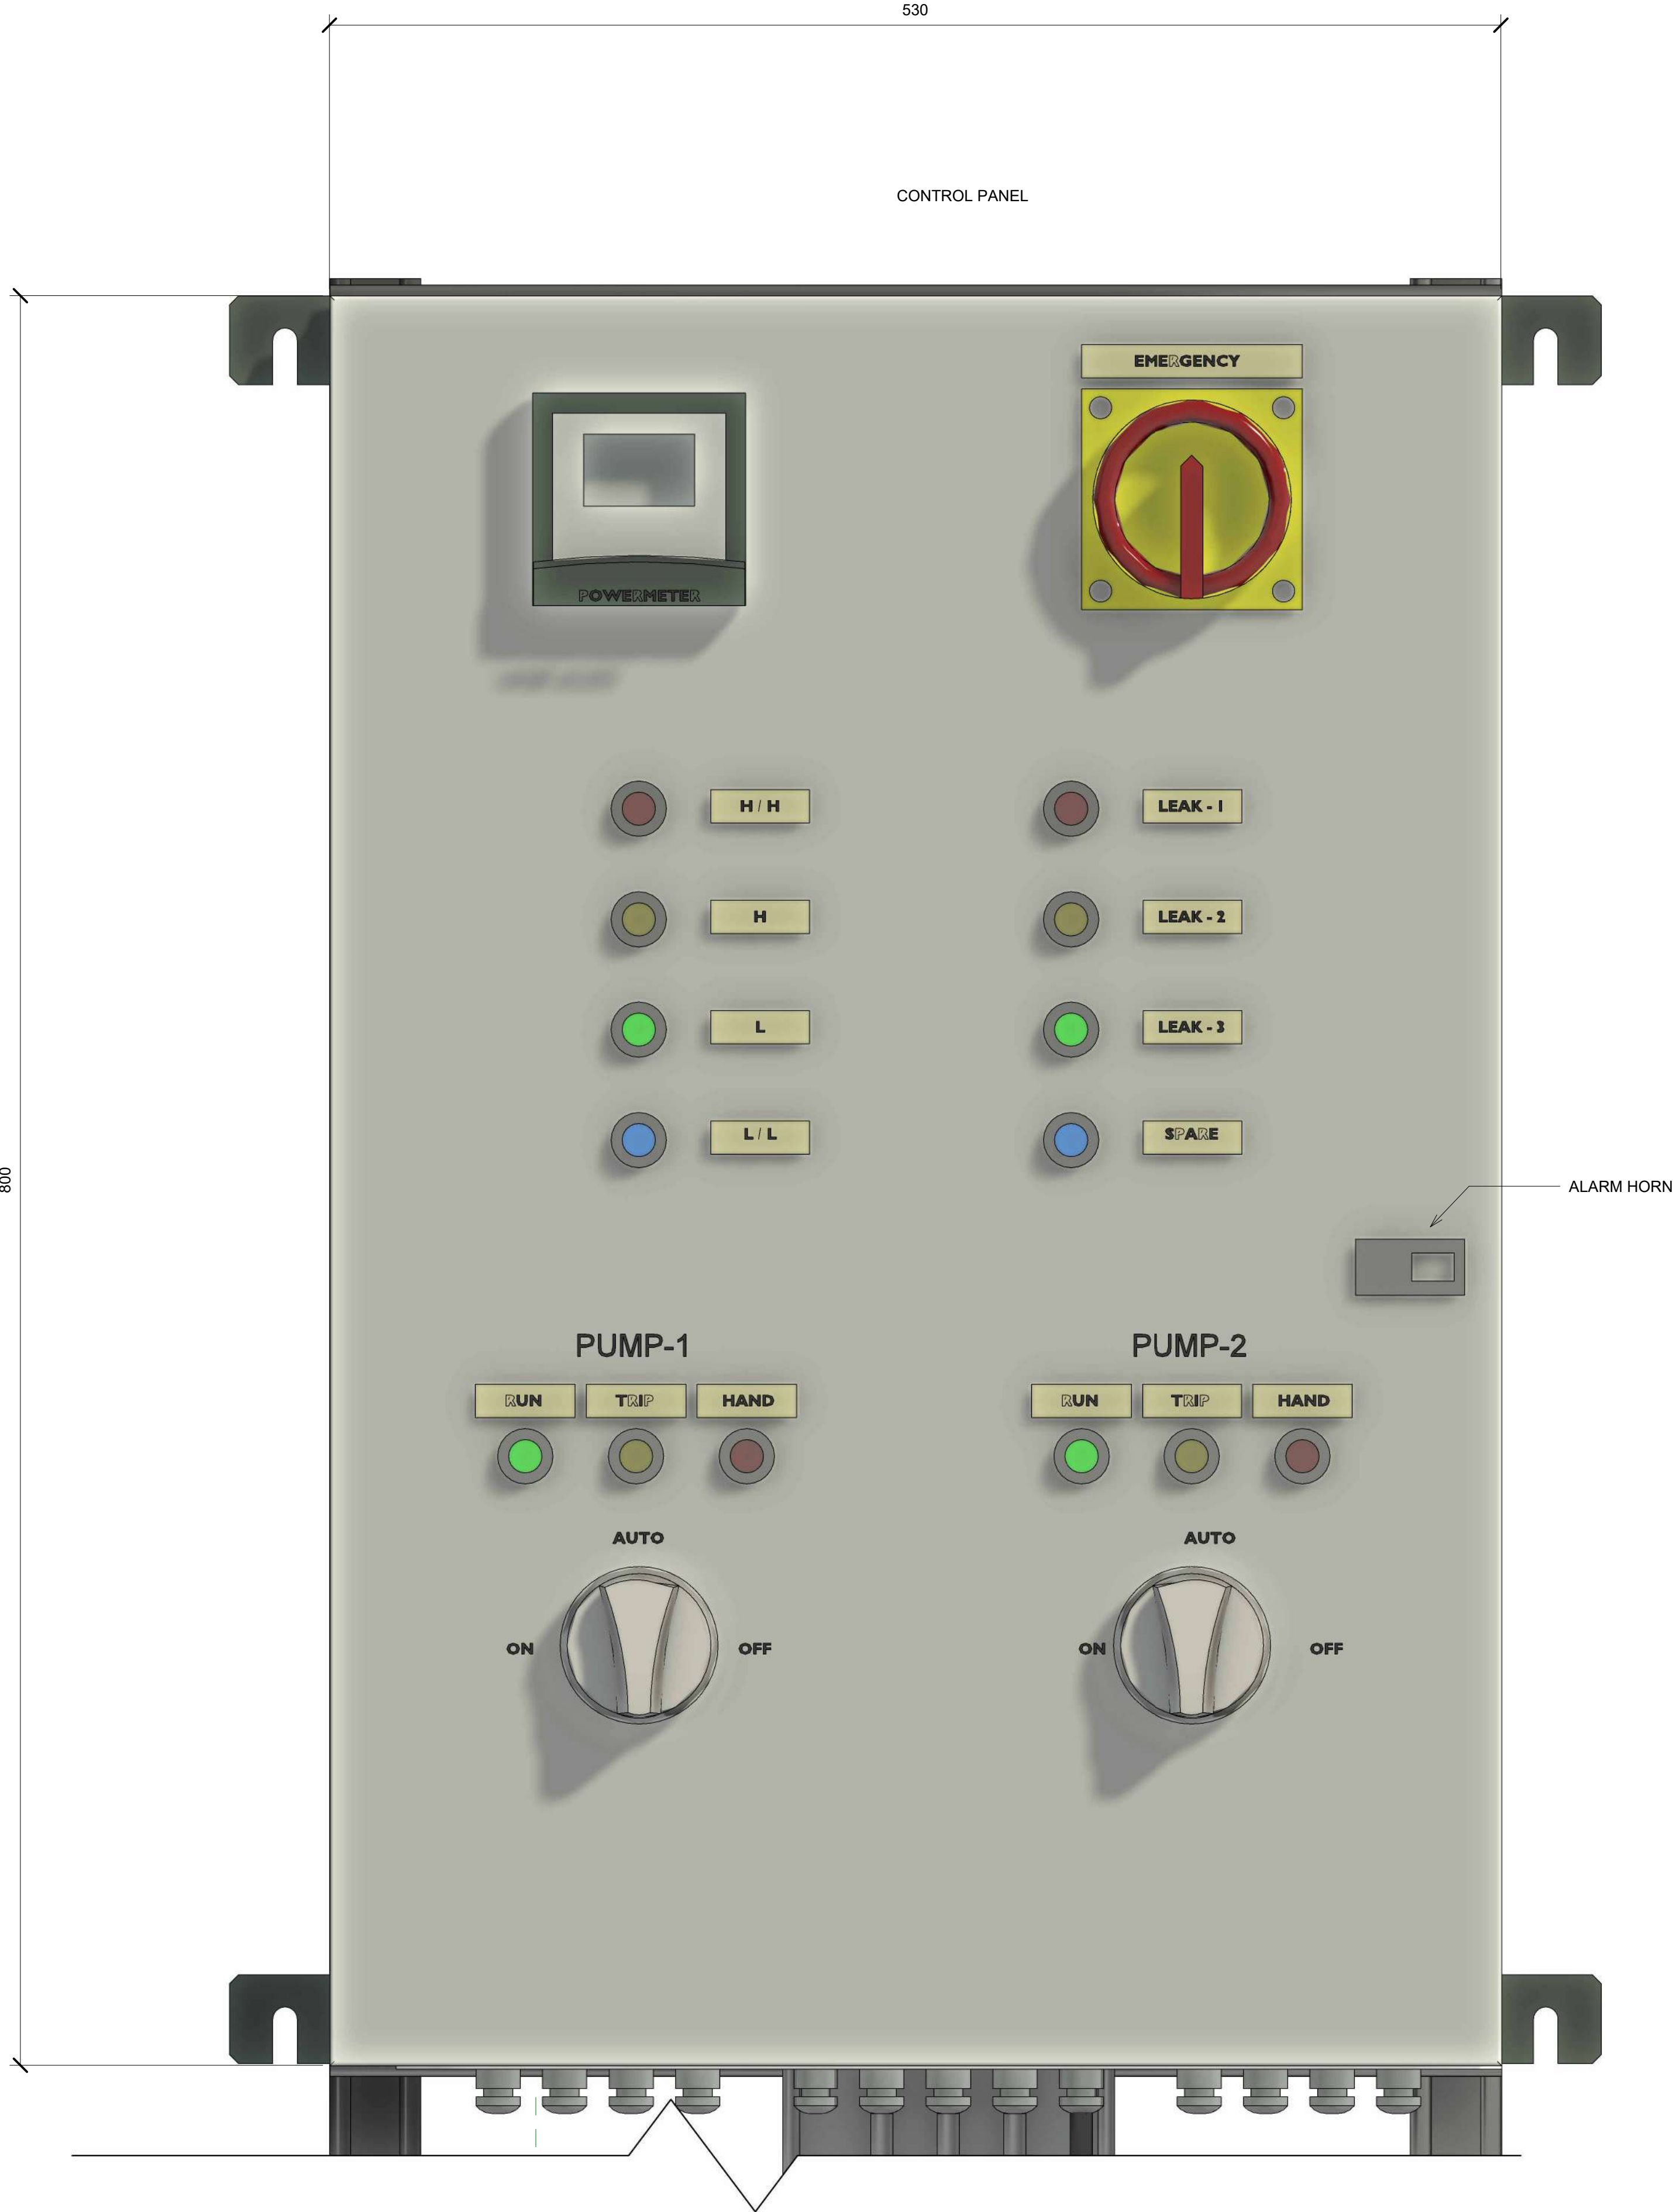

1 CONTROL PANEL - FRONT
1 : 2

			 www.basiiia.com	REVISION HISTORY				PROJECT NAME REDSEA COSTAL VILLAGE - TEMPORARY OFFICE		PROJECT STAGE AS BUILT		DRAWING TITLE CONTROL PANEL FRONT A112									
				No. Date Description Status				PROJECT DESCRIPTION TRANSFER SYSTEM - 6,000L FUEL TANK		DISCIPLINE											
								BUILDING NAME		SCALE 1 : 2											
								DATE 2023-02-27													
								PROJECT NUMBER R03-O03C02		DRAWN BY KN											
								CHECKED BY FS													
								DRAWING STATUS AS BUILT		APPROVED BY YM											

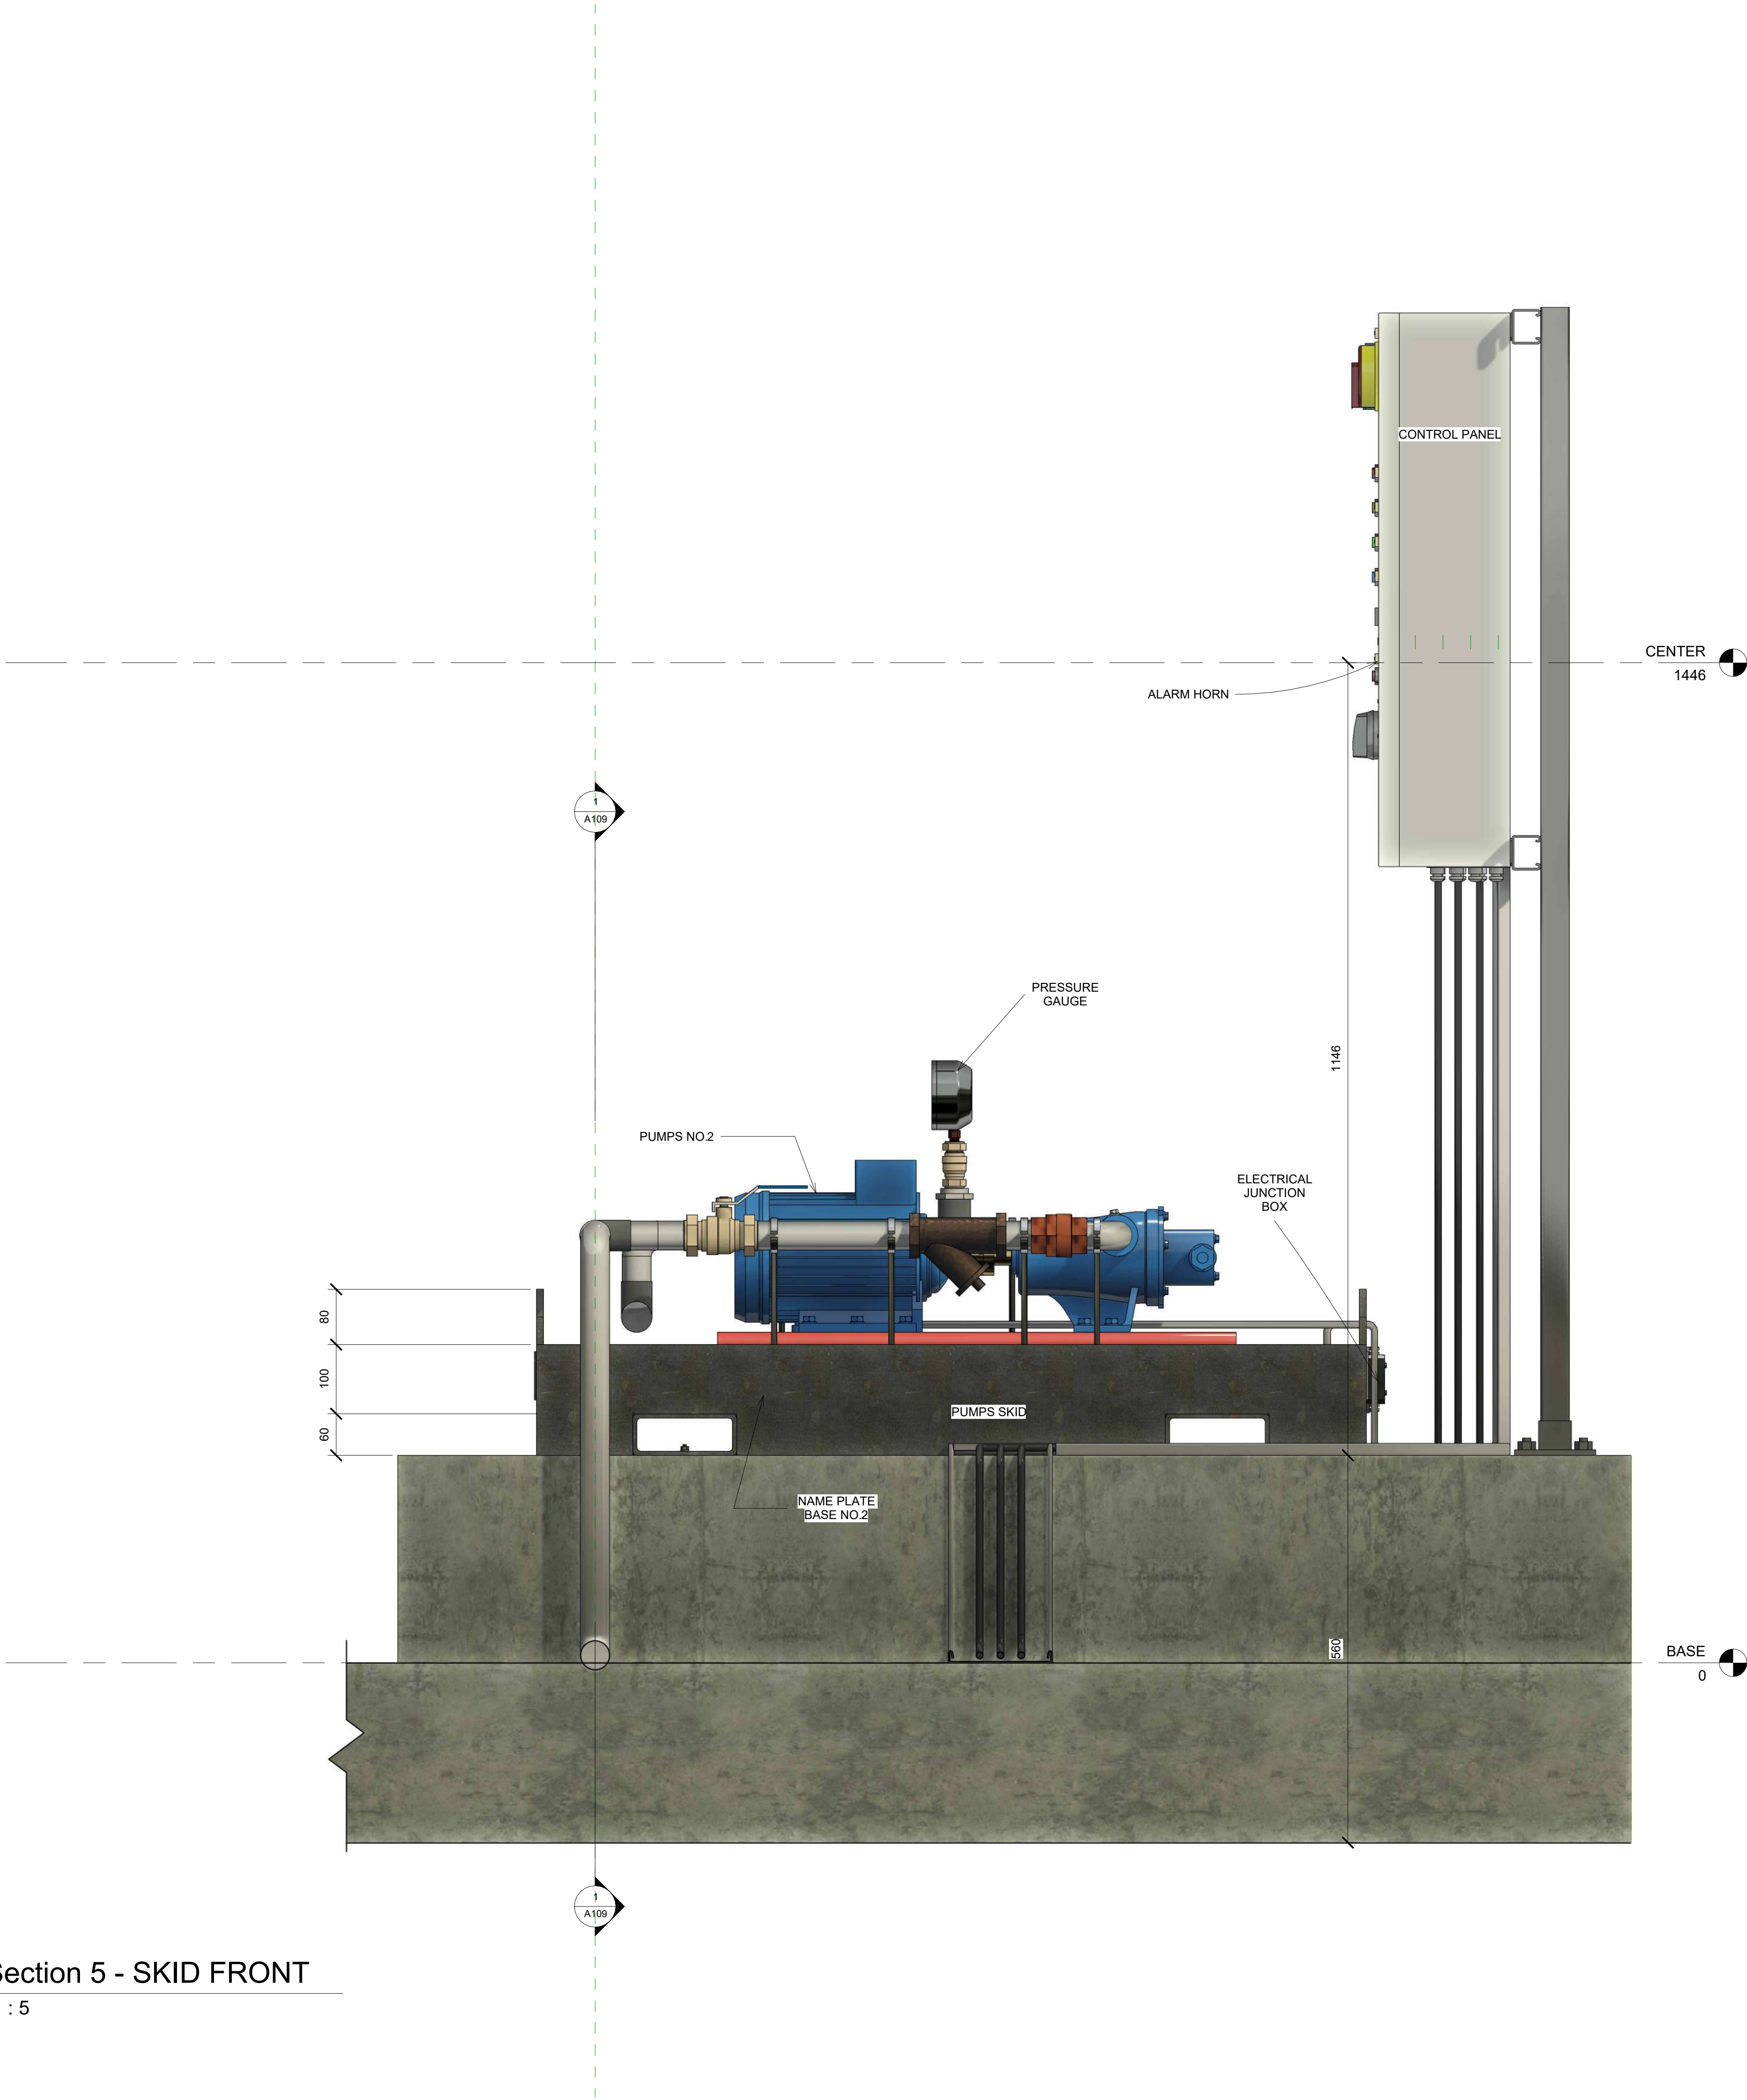

1 Section 5 - SKID FRONT
1 : 5

CLIENT 	CONSULTANT 	CONTRACTOR 	VENDOR  www.basila.com	REVISION HISTORY				PROJECT NAME REDSEA COSTAL VILLAGE - TEMPORARY OFFICE		PROJECT STAGE AS BUILT		DRAWING TITLE SKID FRONT A113 <table><tr><th>PROGRAM CODE</th><th>PROJECT & CONTRACTOR CODE</th><th>ORIGINATOR CODE</th><th>VOLUME / SYSTEM</th><th>BUILDING LEVELS</th><th>DOCUMENT TYPE</th><th>DISCIPLINE</th><th>SERIES NUMBER</th><th>REVISION</th></tr><tr><td></td><td></td><td></td><td></td><td></td><td></td><td></td><td></td><td></td></tr></table>									PROGRAM CODE	PROJECT & CONTRACTOR CODE	ORIGINATOR CODE	VOLUME / SYSTEM	BUILDING LEVELS	DOCUMENT TYPE	DISCIPLINE	SERIES NUMBER	REVISION																																																																																																																																																																																																																																																																																																																																																																																																																																																																																																																																																																																																																																																																																																																																																																																																																																																																																																																																																																																																																																																																																																																																																																																																																																																																																																																																																						
				PROGRAM CODE	PROJECT & CONTRACTOR CODE	ORIGINATOR CODE	VOLUME / SYSTEM	BUILDING LEVELS	DOCUMENT TYPE	DISCIPLINE	SERIES NUMBER										REVISION																																																																																																																																																																																																																																																																																																																																																																																																																																																																																																																																																																																																																																																																																																																																																																																																																																																																																																																																																																																																																																																																																																																																																																																																																																																																																																																																																														
				No.	Date	Description	Status	PROJECT DESCRIPTION TRANSFER SYSTEM - 6,000L FUEL TANK		DISCIPLINE																																																																																																																																																																																																																																																																																																																																																																																																																																																																																																																																																																																																																																																																																																																																																																																																																																																																																																																																																																																																																																																																																																																																																																																																																																																																																																																																																																									
								BUILDING NAME		SCALE 1 : 5																																																																																																																																																																																																																																																																																																																																																																																																																																																																																																																																																																																																																																																																																																																																																																																																																																																																																																																																																																																																																																																																																																																																																																																																																																																																																																																																																																									
								DATE 2023-02-27		DRAWN BY KN																																																																																																																																																																																																																																																																																																																																																																																																																																																																																																																																																																																																																																																																																																																																																																																																																																																																																																																																																																																																																																																																																																																																																																																																																																																																																																																																																																									
								PROJECT NUMBER R03-O03C02		CHECKED BY FS																																																																																																																																																																																																																																																																																																																																																																																																																																																																																																																																																																																																																																																																																																																																																																																																																																																																																																																																																																																																																																																																																																																																																																																																																																																																																																																																																																									
								DRAWING STATUS AS BUILT		APPROVED BY YM																																																																																																																																																																																																																																																																																																																																																																																																																																																																																																																																																																																																																																																																																																																																																																																																																																																																																																																																																																																																																																																																																																																																																																																																																																																																																																																																																																									
																																																																																																																																																																																																																																																																																																																																																																																																																																																																																																																																																																																																																																																																																																																																																																																																																																																																																																																																																																																																																																																																																																																																																																																																																																																																																																																																																																																			</